



**CAUTION-**  
 THE LOCATION OF UNDERGROUND UTILITIES DEPICTED ON THESE DRAWINGS ARE BASED ON VISUAL SURFACE EVIDENCE AND/OR AS-BUILT DRAWINGS PROVIDED BY OTHERS AND, THEREFORE, MAY NOT REPRESENT ALL UTILITIES PRESENT OR THEIR ACTUAL LOCATIONS. IT IS THE CONTRACTOR'S RESPONSIBILITY FOR COORDINATING WITH INDIVIDUAL UTILITY OWNERS TO ASCERTAIN THE EXACT LOCATION OF EXISTING UTILITIES AT SPECIFIC POINTS OF CONNECTION AND FOR NOTIFYING THE CALL OKIE ONE CALL SYSTEM AT 1-800-522-6543 PRIOR TO ANY EXCAVATION ON SITE.

**LEGEND**

- PROPOSED CONCRETE SIDEWALK
- PROPOSED ASPHALT PAVEMENT
- PROPOSED CONCRETE PAVEMENT
- PROPOSED AGGREGATE
- PROPOSED PARKING ROW COUNT

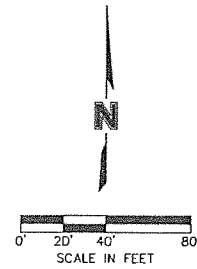

**LOCATION MAP**

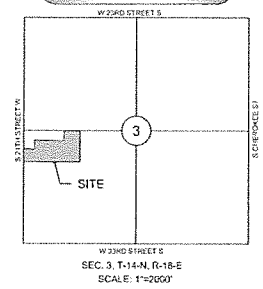


**MOLSSON ASSOCIATES**  
 Civil Engineering  
 1717 S. BUILDER AVE., SUITE 600  
 TULSA, OK 74119  
 TEL: 918.736.4294  
 FAX: 918.736.2118  
 www.molssonassociates.com



**KEYNOTES:**

- 1 PROPOSED CONCRETE SIDEWALK (REF. DETAIL SHEET - DETAIL 1)
- 2 EDGE OF PROPOSED PAVEMENT
- 3 PROPOSED ASPHALT PAVEMENT (REF. DETAIL SHEET - DETAIL 2)
- 4 PROPOSED CONCRETE PAVEMENT (REF. DETAIL SHEET - DETAIL 3)
- 5 PROPOSED LIGHT POLE (REF. ELECTRICAL PLANS)
- 6 CONCRETE CURB AND GUTTER (REF. DETAIL SHEET - DETAIL 4)
- 7 PROPOSED SCALE
- 8 PROPOSED 4" PARKING STRIPE (WHITE)
- 9 PROPOSED AGGREGATE ROCK LANDSCAPE BEDDING
- 10 PROPOSED CONCRETE RAMP (REF. ENLARGED GRADING PLAN - SHEET C-108 FOR SPOT ELEVATIONS)
- 11 PROPOSED CHAINLINK FENCE WITH 3-STRAND BARBED WIRE (MATCH EXISTING ONSITE FENCING)
- 12 PROPOSED 4" PARKING STRIPE (YELLOW)
- 13 BOLLARD (REF. DETAIL SHEET - DETAIL 5)
- 14 EXISTING FUEL STATION - PROTECT DURING CONSTRUCTION
- 15 EXISTING FENCE - PROTECT DURING CONSTRUCTION
- 16 EXISTING CONCRETE PAVEMENT - PROTECT DURING CONSTRUCTION
- 17 PROPOSED LOCATION OF MAILBOX
- 18 PROPOSED TURNSTILE TYPE HS430-S (REF. TO ARCHITECTURAL SPECIFICATIONS)
- 19 PROPOSED HANDRAIL INSTALL ON 6" RETAINING WALL (REF. TO ARCHITECTURAL PLANS)


<b>PARKING COUNT:</b>	
TRUCK PARKING:	56
EMPLOYEE PARKING:	101

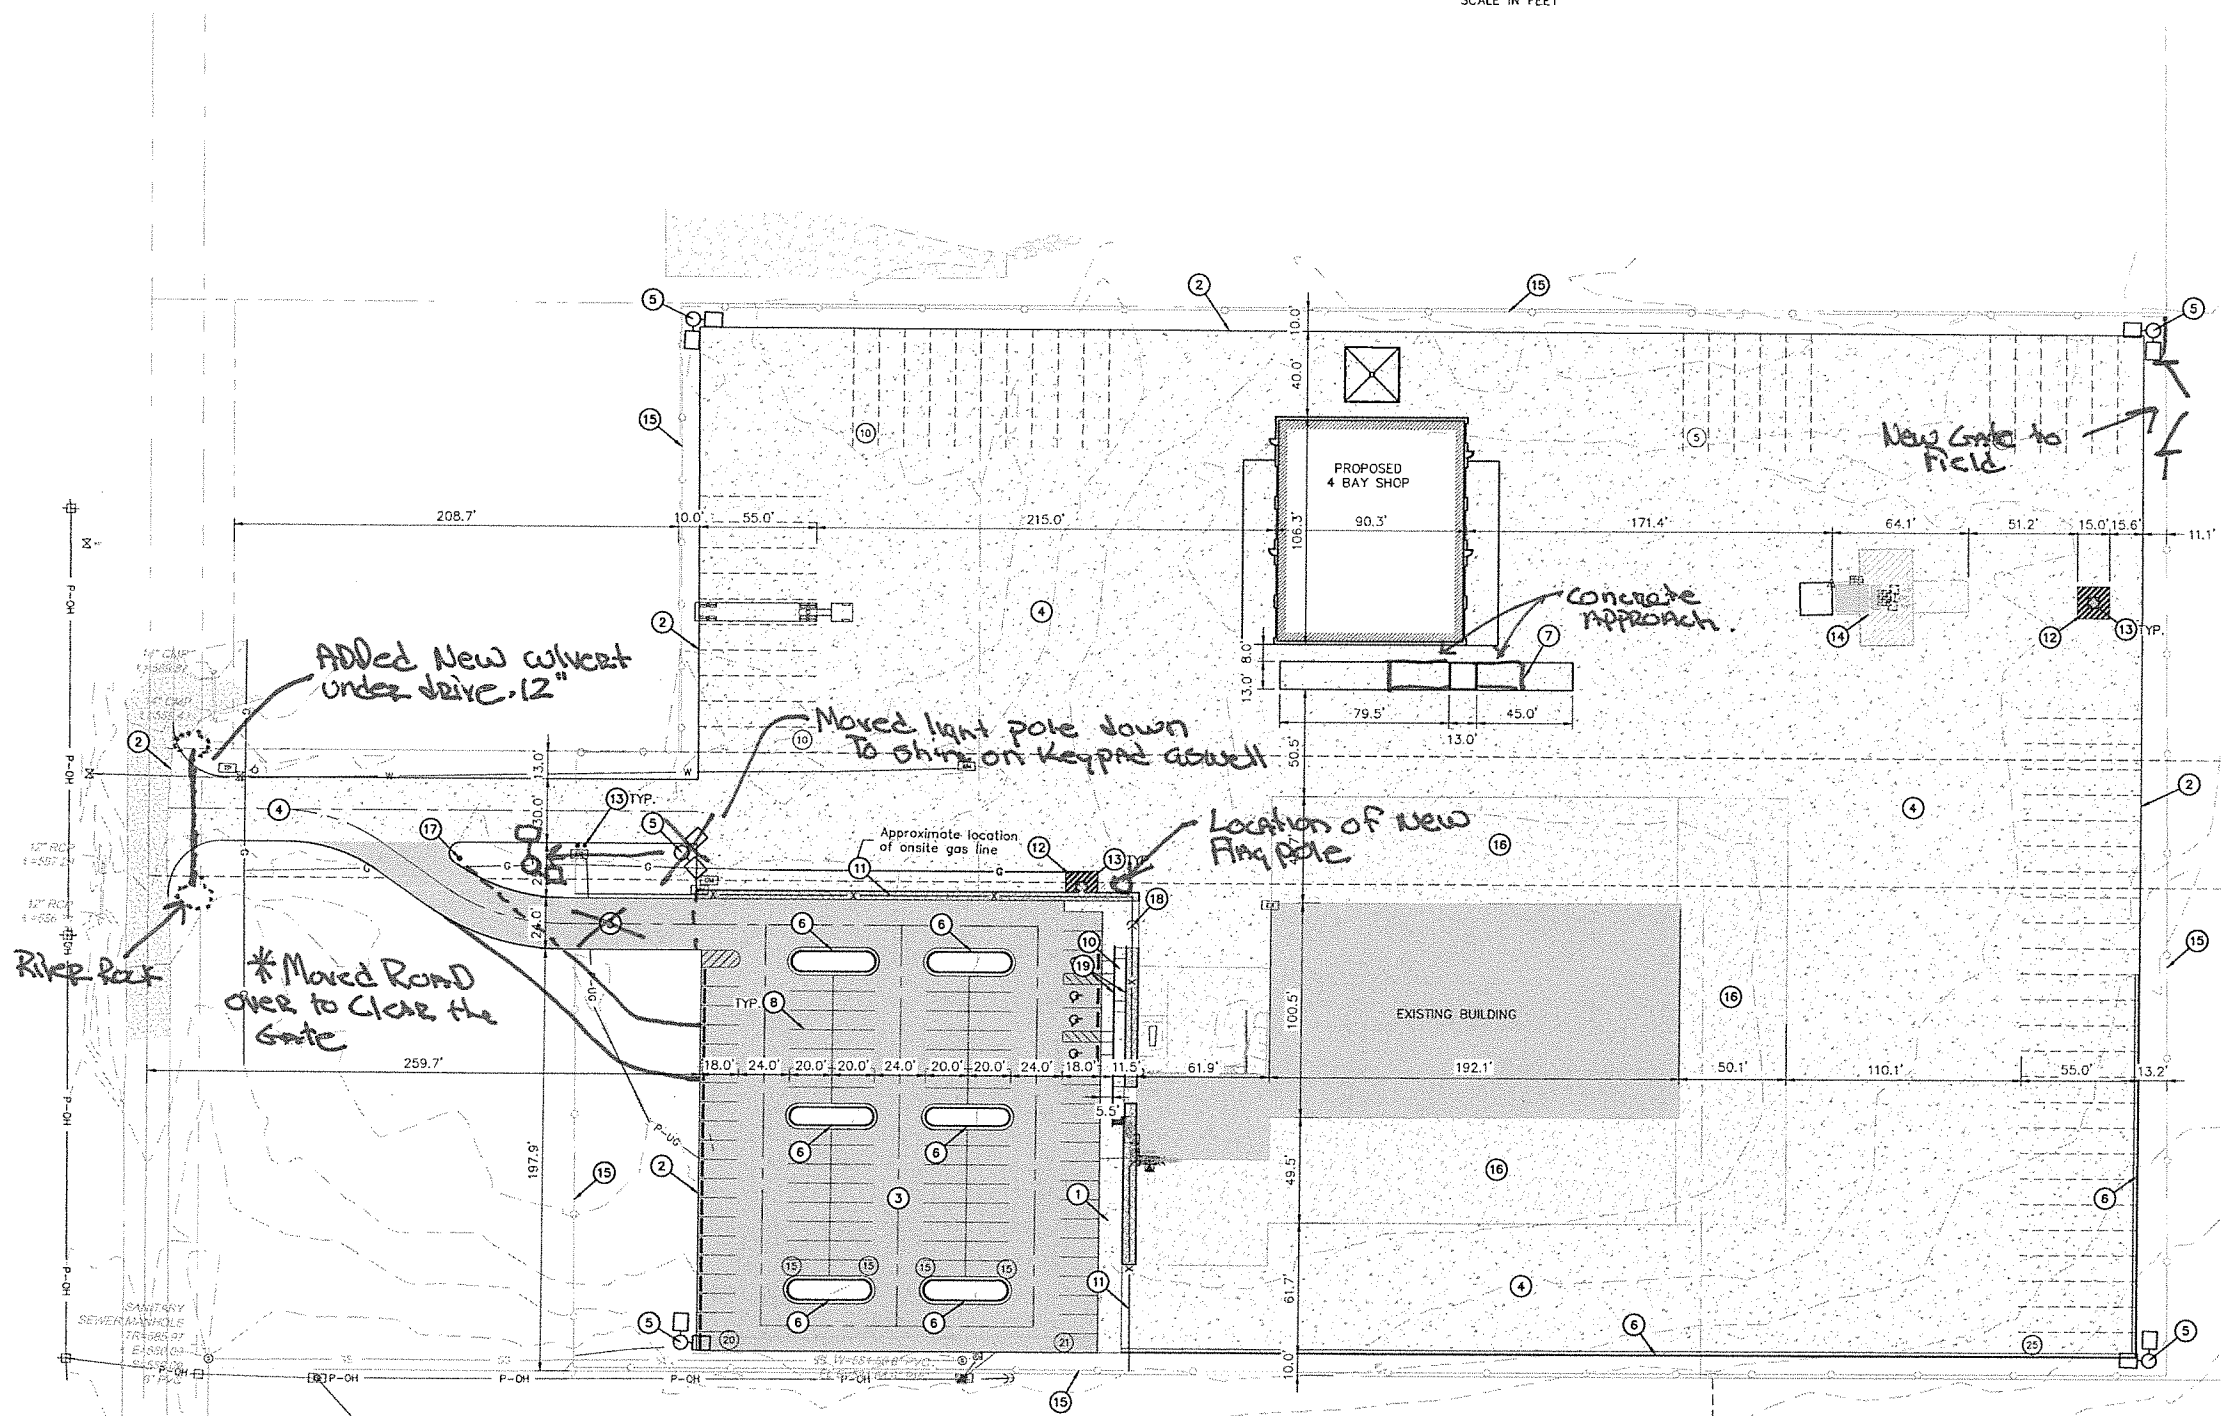

DWG: F:\2017\1501-2000\017-1619 v40-Design\AutoCAD\Final Plans\GNDV\01\_Site Plans\_36x24\C\_S101\_71619.dwg  
 DATE: Oct 17, 2017 8:12am  
 USER: mvanover

NO.	REV.	DATE	DESCRIPTION

SITE PLAN  
 R+L CARRIERS  
 MUSKOGEE PROJECT - 2017  
 MUSKOGEE, OK  
 2017

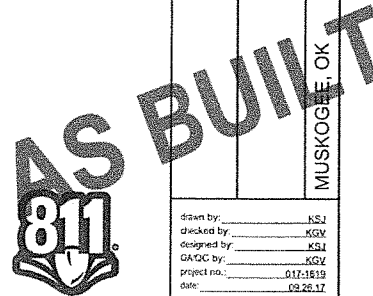

drawn by: KSG  
 checked by: KSG  
 designed by: KSG  
 GACG by: KSG  
 project no.: 017-1619  
 date: 02-28-17

SHEET C-106